


CREATIVE ENGINEERING
 SERVICES
 5872 Sycamore Street
 Duncan, BC V9L 3E4
 tel/fax 250.748.4876
 profeng@shaw.ca

LOT 49 *The Linden*

Lot 49, Falcon Crescent
 Cowichan Bay, BC

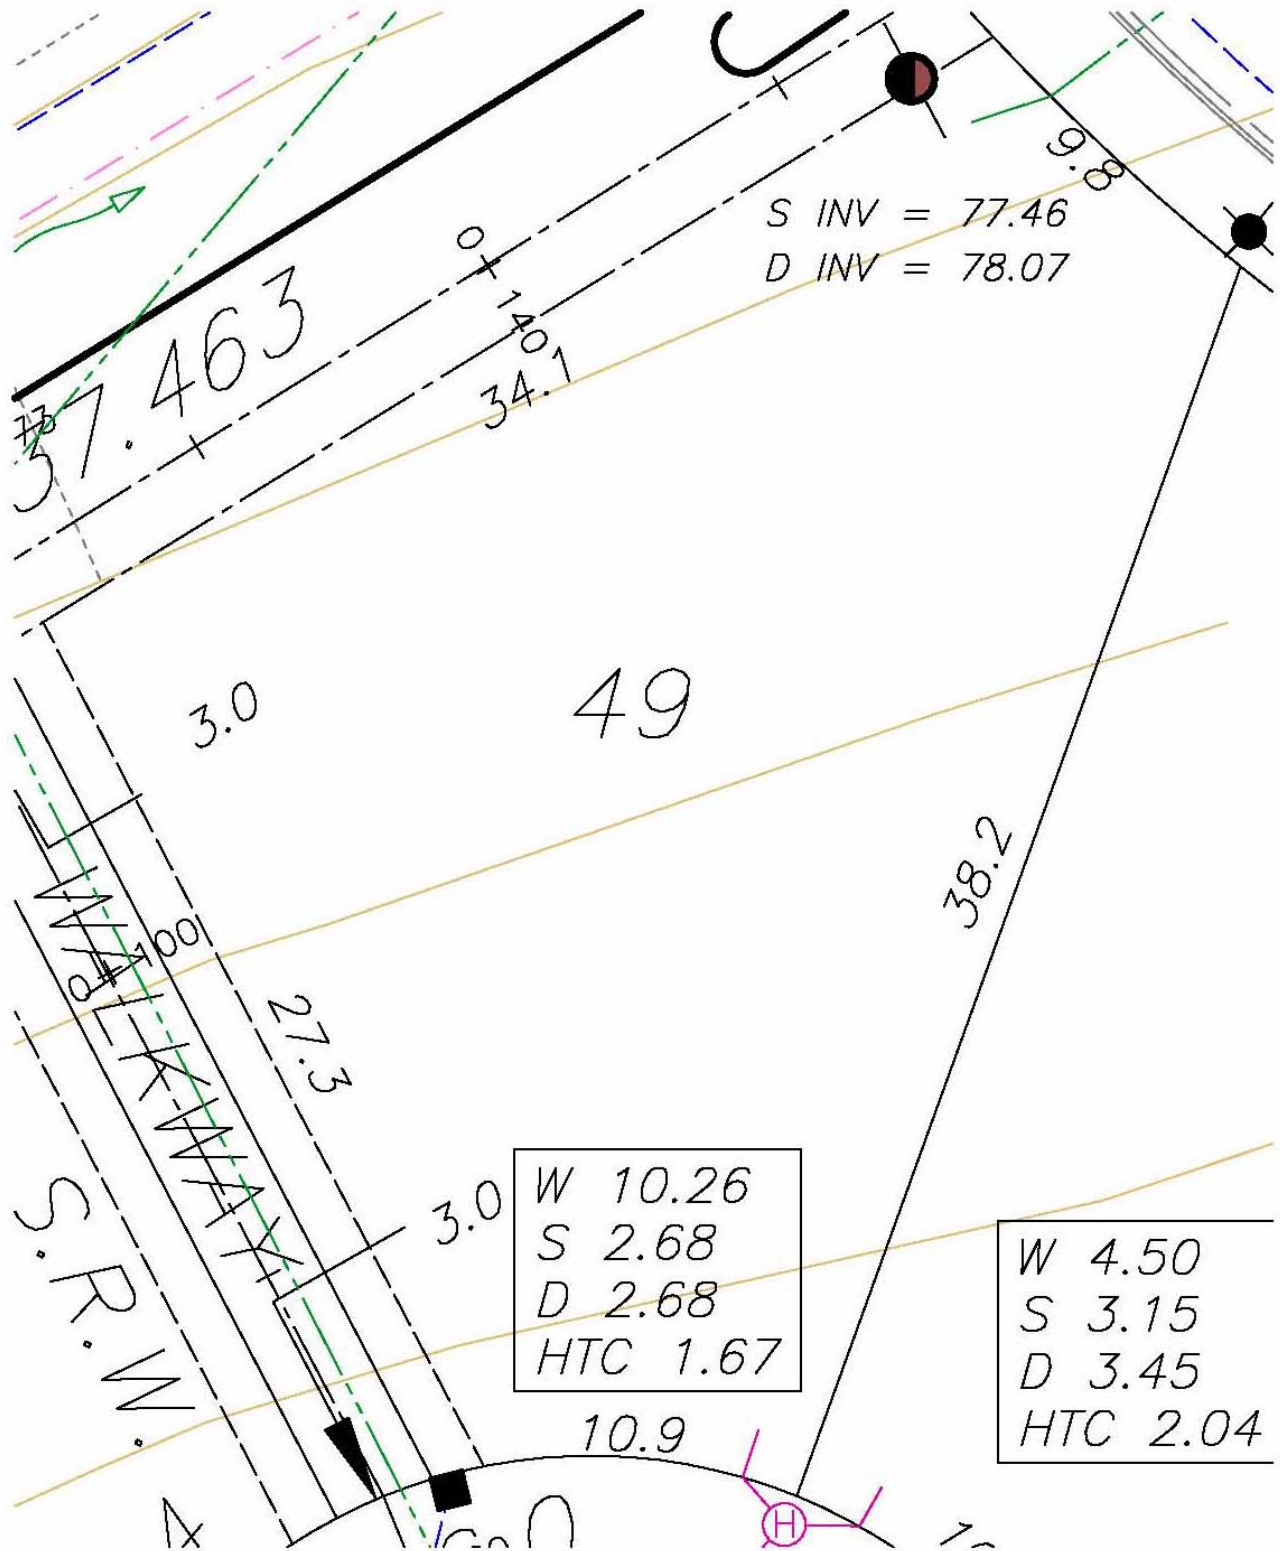

Dimensions and information shown are derived from as built plans.
 Refer to legal survey plan VIP 81580 for true dimensions.

SCALE = 1:250